


AS-BUILT SURVEY
LOTTIS CREEK CAMPGROUND – PARK CONE LOOP
TAYLOR RIVER ROAD (FS RD 742)
SECTION 2, T 15 S, R 83 W, 6th PM
GUNNISON COUNTY, COLORADO



AS-BUILT SURVEY
LOTTIS CREEK CAMPGROUND – PARK CONE LOOP
TAYLOR RIVER ROAD (FOREST SERVICE ROAD 742)
GUNNISON COUNTY, COLORADO

MATCH SHEET 2

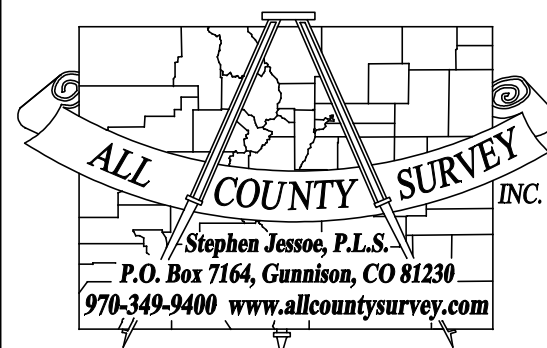

LAND DESCRIPTION


Lottis Creek Campground – Park Cone Loop
U.S. Forest Service – Gunnison National Forest
Section 2, T 15 S, R 83 W, 6th P.M.
County of Gunnison
State of Colorado

SURVEY NOTES



- 1) Elevations, survey control, topographic information and tree locations provided by the US Forest Service, Gunnison Office.
- 2) Basis of bearing based upon control points TP-24 and CP-7 as shown hereon. Control information provided by the US Forest Service, Gunnison office.
- 3) Distances and dimensions are in U.S. Survey Feet.

SURVEYOR'S STATEMENT

I, STEPHEN L. JESSOE, being a Licensed Professional Land Surveyor in the State of Colorado, do hereby state that this As-Built Survey was prepared by me and under my supervision and that both the survey, conducted on 22–28 September 2011, and map are true and accurate to the best of my knowledge and belief.

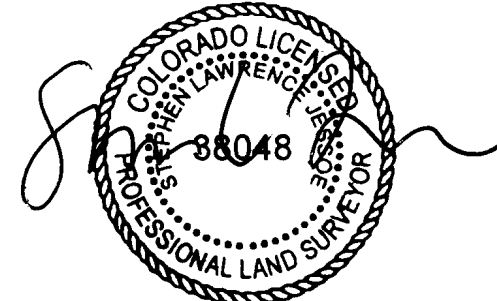

Stephen L. Jessoe Date 31 October 2011
Colorado Licensed Professional Land Surveyor No. 38048

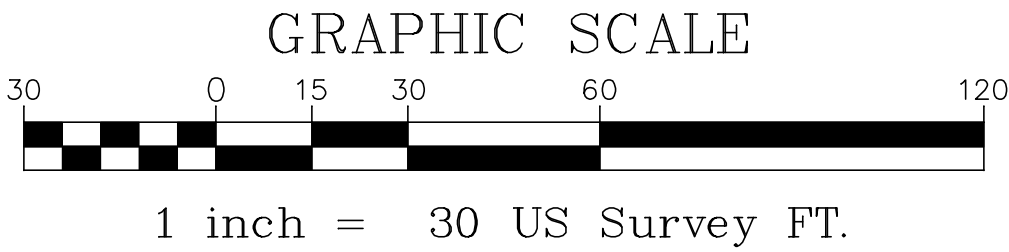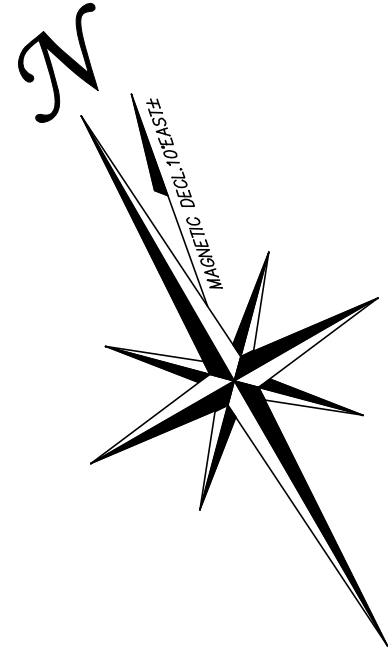

SCALE: 1" = 30'
CONTOUR INTERVAL: 2 FEET
CONTOURS FROM BASE MAP
PROVIDED BY FOREST SERVICE

According to Colorado Law, you must commence any legal action based upon any defect in this survey within three years after you first discover such defect. In no event may any legal action based upon any defect in this survey be commenced more than ten years from the date of the certification shown hereon.


DATE: 10/31/11
DRAWN BY: ADJ
REVIEWED BY: SLJ

REVISIONS:

AS-BUILT SURVEY
LOTTIS CREEK CAMPGROUND
TAYLOR RIVER ROAD
Sec.2, T15S, R83W, 6th PM
GUNNISON COUNTY, COLORADO

AS-BUILT SURVEY
LOTTIS CREEK CAMPGROUND – GROUP USE & HOST SITE
TAYLOR RIVER ROAD (FS RD 742)
SECTION 2, T 15 S, R 83 W, 6th PM
GUNNISON COUNTY, COLORADO

MATCH SHEET 3

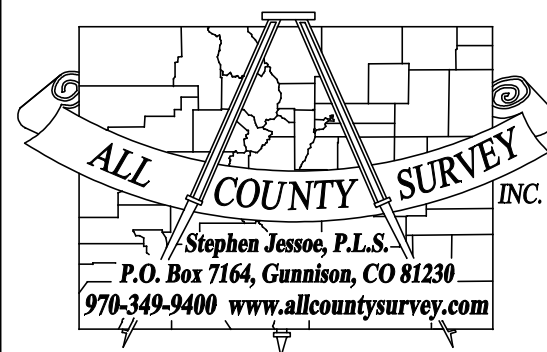

AS-BUILT SURVEY
LOTTIS CREEK C.G. – GROUP USE & HOST SITE
TAYLOR RIVER ROAD (FOREST SERVICE ROAD 742)
GUNNISON COUNTY, COLORADO

SCALE: 1" = 30'
CONTOUR INTERVAL: 2 FEET
CONTOURS FROM BASE MAP
PROVIDED BY FOREST SERVICE

According to Colorado Law, you must commence any legal action based upon any defect in this survey within three years after you first discover such defect. In no event may any legal action based upon any defect in this survey be commenced more than ten years from the date of the certification shown hereon.


DATE: 10/31/11
DRAWN BY: ADJ
REVIEWED BY: SLJ

REVISIONS:

AS-BUILT SURVEY
LOTTIS CREEK CAMPGROUND
TAYLOR RIVER ROAD
Sec.2, T15S, R83W, 6th PM
GUNNISON COUNTY, COLORADO

LEGEND

- SURVEY CONTROL
- FIRE PIT
- TRAFFIC SIGN
- CAMP SITE SIGN
- BOULDER RETAINING WALL
- CONCRETE PAD
- ASPHALT
- GRAVEL EDGE
- BARBED WIRE FENCE
- TIMBERS
- ELECTRIC LINE
- ELECTRIC PANEL
- ELECTRIC PEDESTAL
- ELECTRIC METER
- ELECTRIC TRANSFORMER
- LIGHT POLE
- SEWER LINE
- AIR RELEASE VALVE
- SEWER CLEAN OUT
- TELEPHONE LINE
- TELEPHONE PEDESTAL
- WATER, ELECTRIC, TELEPHONE LINE
- WATER, ELECTRIC LINE
- WATER LINE
- CURB STOP
- DRAIN FOR WATER LINE
- WATER SPIGOT
- WATER VALVE
- WATER HOOKUP FOR HOST
- WELL HEAD
- CAMP SITE NUMBER

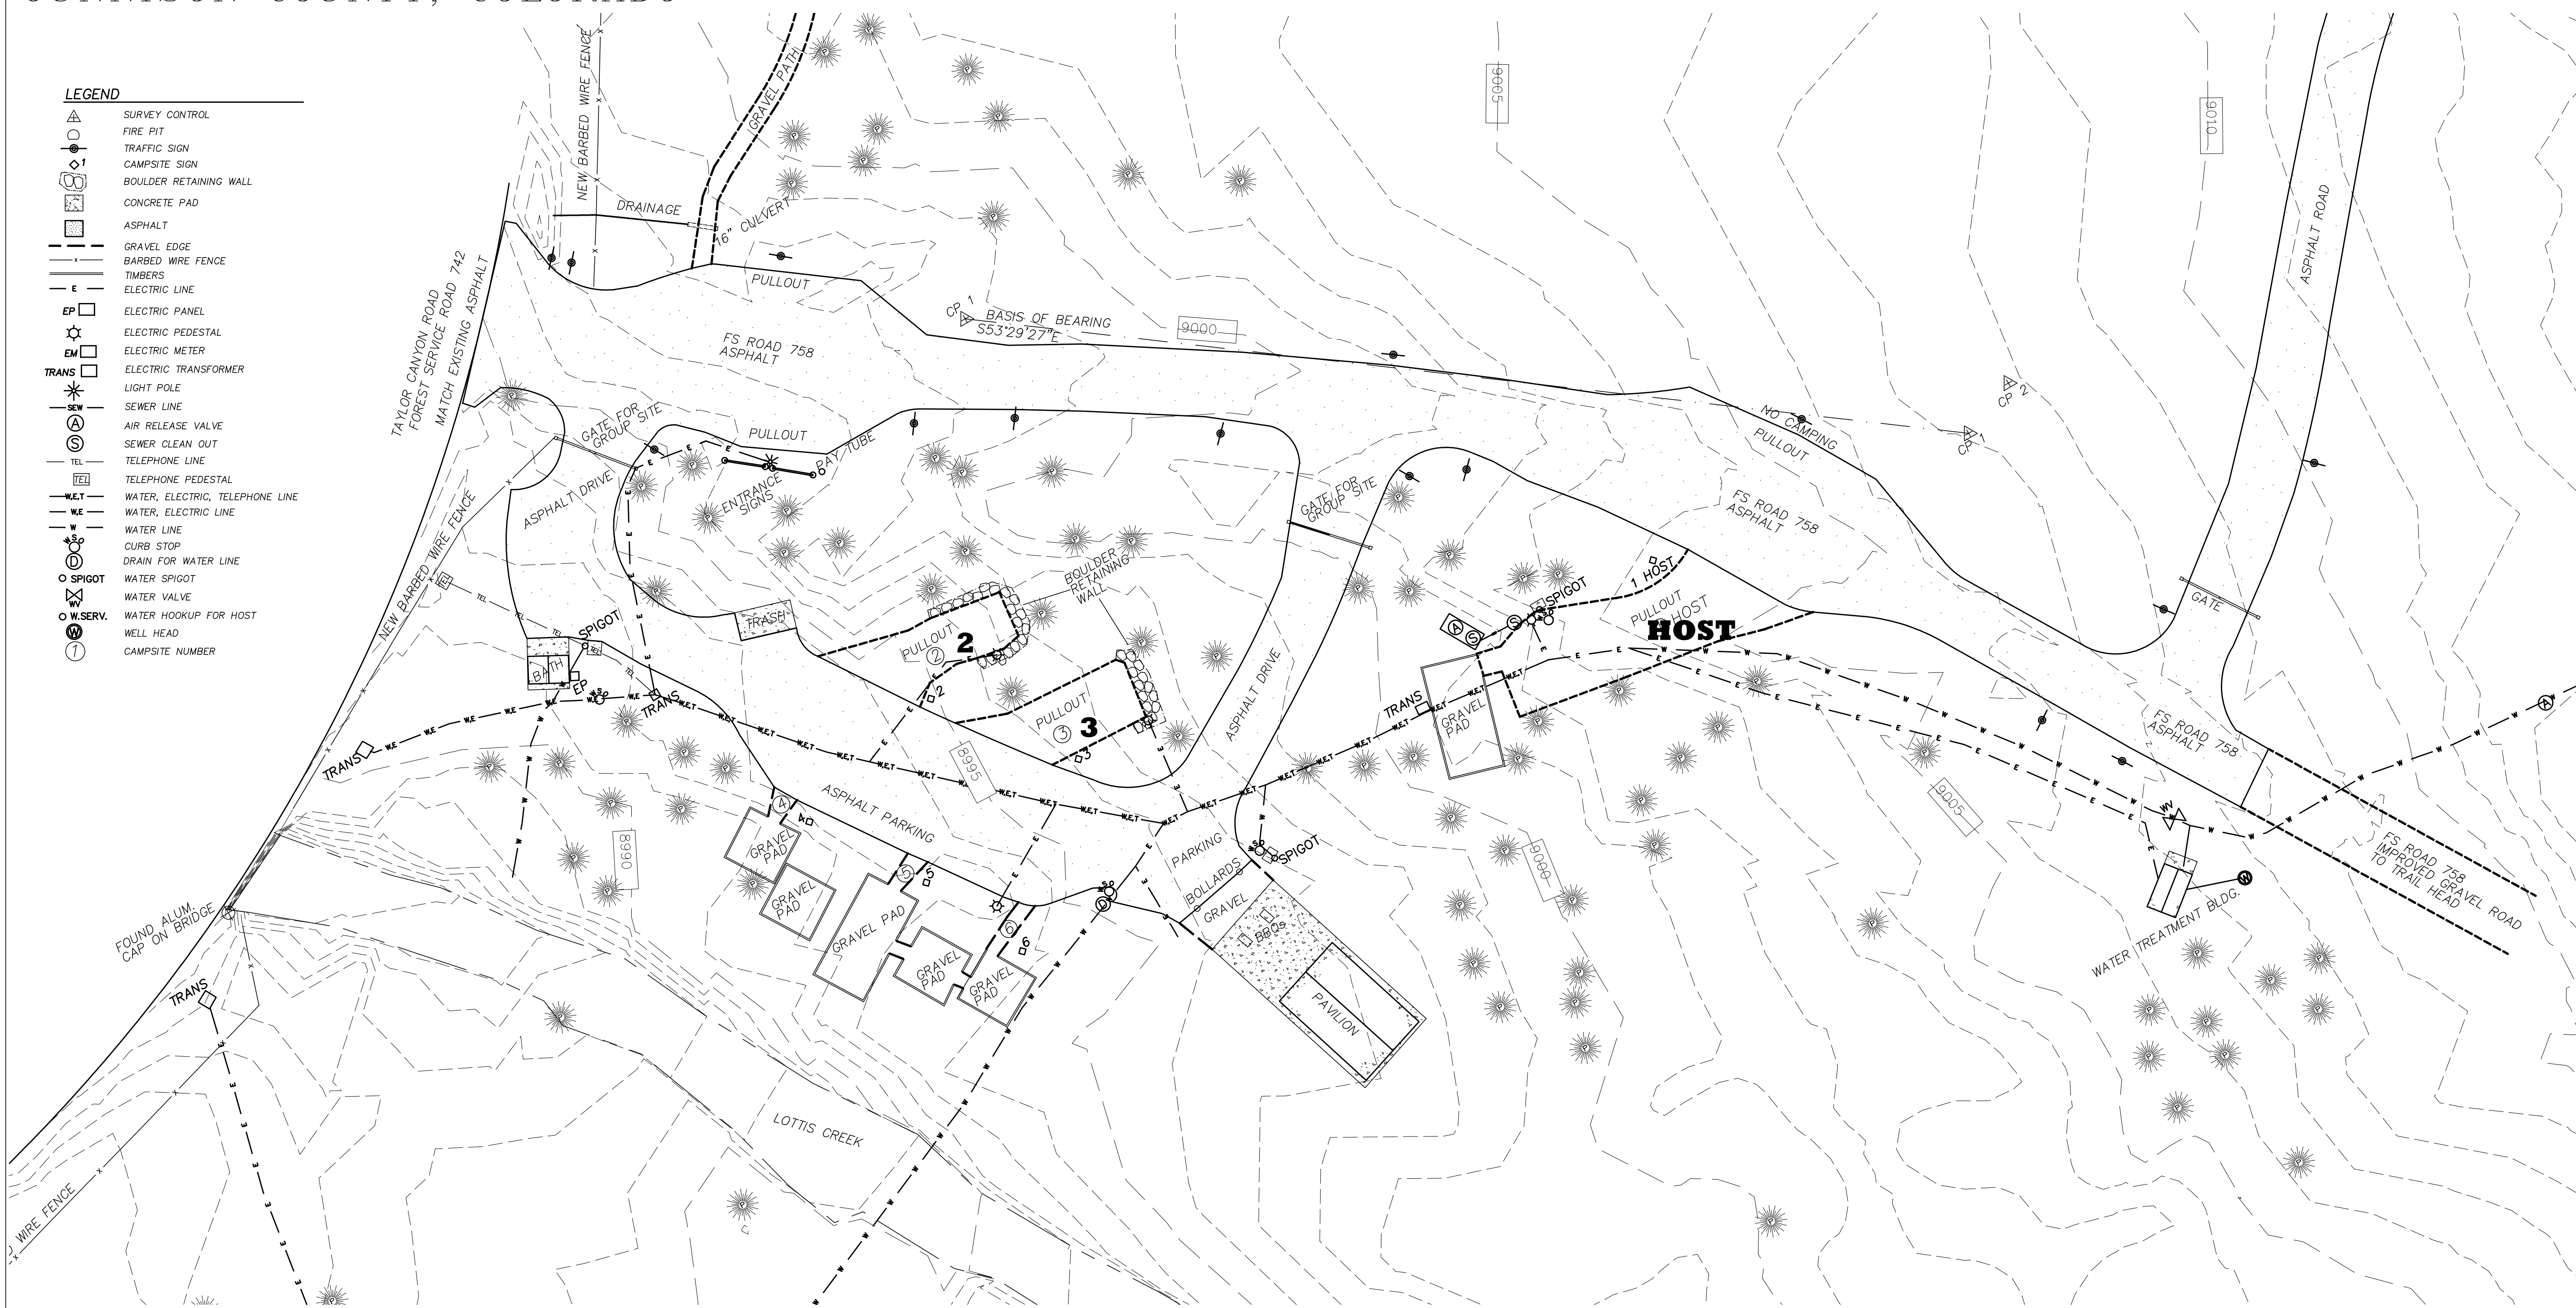

MATCH SHEET 1

MATCH SHEET 4

LAND DESCRIPTION

Lottis Creek Campground – Group Use & Host Site
U.S. Forest Service – Gunnison National Forest
SECTION 2, T 15 S, R 83 W, 6th PM
County of Gunnison
State of Colorado

SURVEY NOTES

- Elevations, survey control, topographic information and tree locations provided by the US Forest Service, Gunnison Office.
- Basis of bearing based upon control points CP-1 and CP-1 as shown hereon. Control information provided by the US Forest Service, Gunnison office.
- Distances and dimensions are in U.S. Survey Feet.

SURVEYOR'S STATEMENT



I, STEPHEN L. JESSOE, being a Licensed Professional Land Surveyor in the State of Colorado, do hereby state that this As-Built Survey was prepared by me and under my supervision and that both the survey, conducted on 22-28 September 2011, and map are true and accurate to the best of my knowledge and belief.




Stephen L. Jesso
Colorado Licensed Professional Land Surveyor No. 38048

31 October 2011

Date

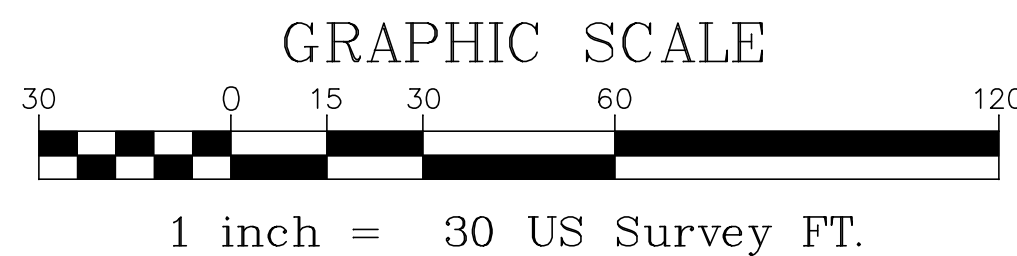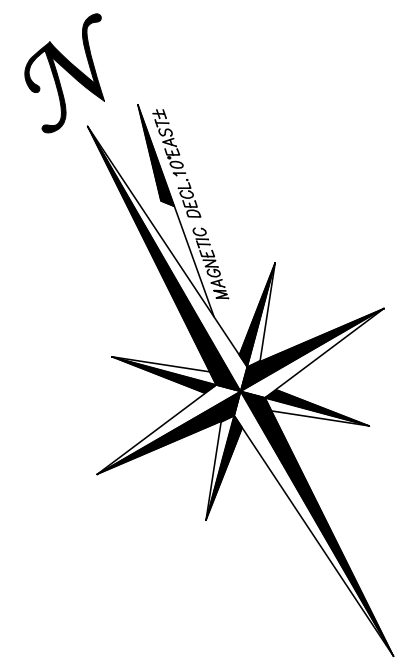

AS-BUILT SURVEY
LOTTIS CREEK CAMPGROUND – BALDY LOOP
TAYLOR RIVER ROAD (FS RD 742)
SECTION 2, T 15 S, R 83 W, 6th PM
GUNNISON COUNTY, COLORADO

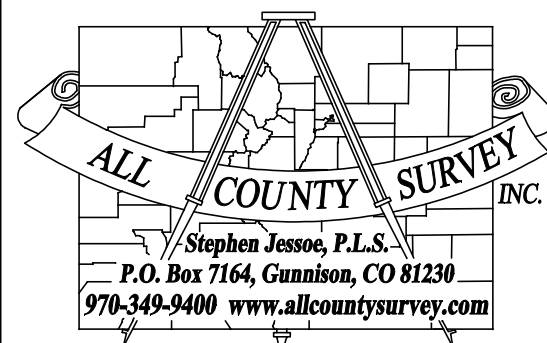

AS-BUILT SURVEY
LOTTIS CREEK CAMPGROUND – BALDY LOOP
TAYLOR RIVER ROAD (FOREST SERVICE ROAD 742)
GUNNISON COUNTY, COLORADO

SCALE: 1" = 30'
CONTOUR INTERVAL: 2 FEET
CONTOURS FROM BASE MAP
PROVIDED BY FOREST SERVICE

According to Colorado Law, you must commence any legal action based upon any defect in this survey within three years after you first discover such defect. In no event may any legal action based upon any defect in this survey be commenced more than ten years from the date of the certification shown hereon.

DATE: 10/31/11
DRAWN BY: ADJ
REVIEWED BY: SLJ

REVISIONS:

AS-BUILT SURVEY
LOTTIS CREEK CAMPGROUND
TAYLOR RIVER ROAD
Sec.2, T15S, R83W, 6th PM
GUNNISON COUNTY, COLORADO

LEGEND

- SURVEY CONTROL
- FIRE PIT
- TRAFFIC SIGN
- CAMP SITE SIGN
- BOULDER RETAINING WALL
- CONCRETE PAD
- ASPHALT
- GRAVEL EDGE
- BARBED WIRE FENCE
- TIMBERS
- ELECTRIC LINE
- ELECTRIC PANEL
- ELECTRIC PEDESTAL
- ELECTRIC METER
- ELECTRIC TRANSFORMER
- LIGHT POLE
- SEWER LINE
- AIR RELEASE VALVE
- SEWER CLEAN OUT
- TELEPHONE LINE
- TELEPHONE PEDESTAL
- WATER, ELECTRIC, TELEPHONE LINE
- WATER, ELECTRIC LINE
- WATER LINE
- CURB STOP
- DRAIN FOR WATER LINE
- WATER SPIGOT
- WATER VALVE
- WATER HOOKUP FOR HOST
- WELL HEAD
- CAMP SITE NUMBER

LAND DESCRIPTION


Lottis Creek Campground – Park Cone Loop
U.S. Forest Service – Gunnison National Forest
Section 2, T 15 S, R 83 W, 6th P.M.
County of Gunnison
State of Colorado

SURVEY NOTES

- Elevations, survey control, topographic information and tree locations provided by the US Forest Service, Gunnison Office.
- Basis of bearing based upon control points CP-5 and CP-3 as shown hereon. Control information provided by the US Forest Service, Gunnison office.
- Distances and dimensions are in U.S. Survey Feet.


SURVEYOR'S STATEMENT

I, STEPHEN L. JESSE, being a Licensed Professional Land Surveyor in the State of Colorado, do hereby state that this As-Built Survey was prepared by me and under my supervision and that both the survey, conducted on 22–28 September 2011, and map are true and accurate to the best of my knowledge and belief.

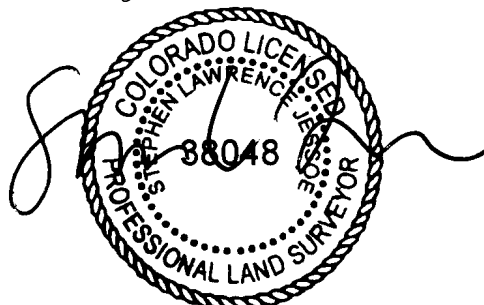

31 October 2011

Stephen L. Jesse Date
Colorado Licensed Professional Land Surveyor No. 38048
For and on behalf of All County Survey, Inc.

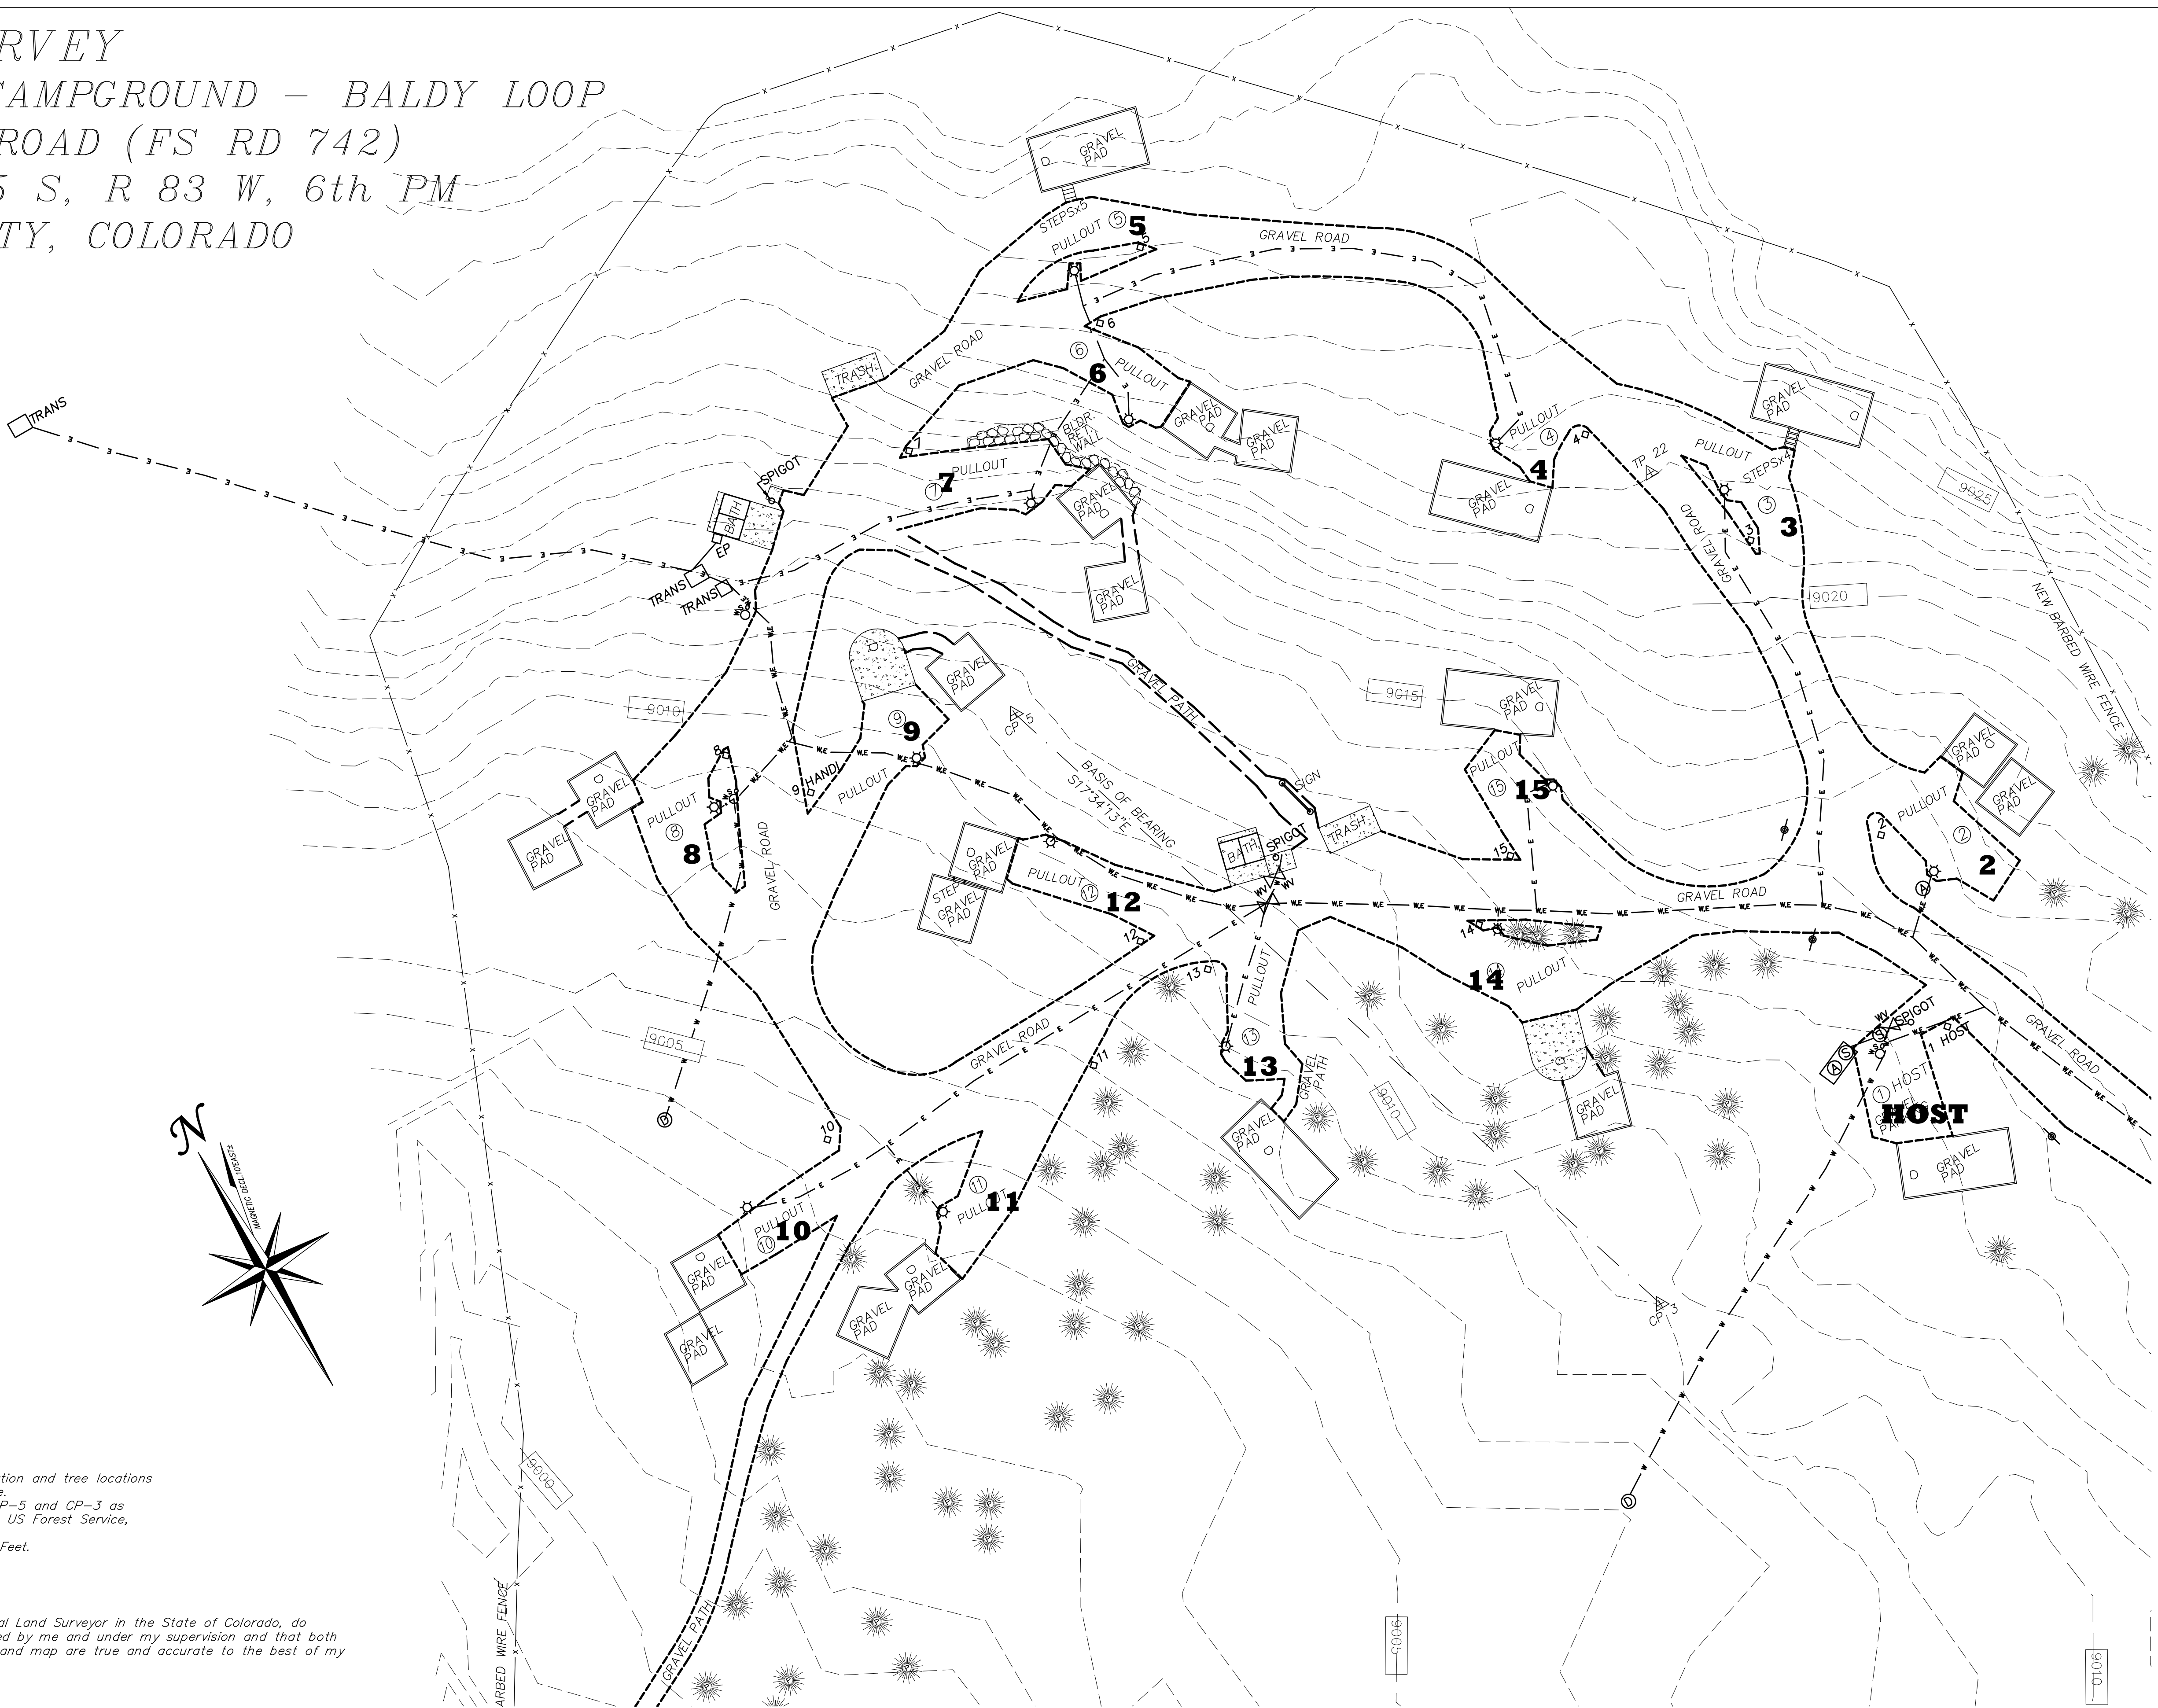


MATCH SHEET 2

GRAPHIC SCALE



1 inch = 30 US Survey FT.

AS-BUILT SURVEY
LOTTIS CREEK CAMPGROUND – UNION PARK LOOP
FOREST SERVICE ROAD 758
SECTION 2, T 15 S, R 83 W, 6th PM
GUNNISON COUNTY, COLORADO

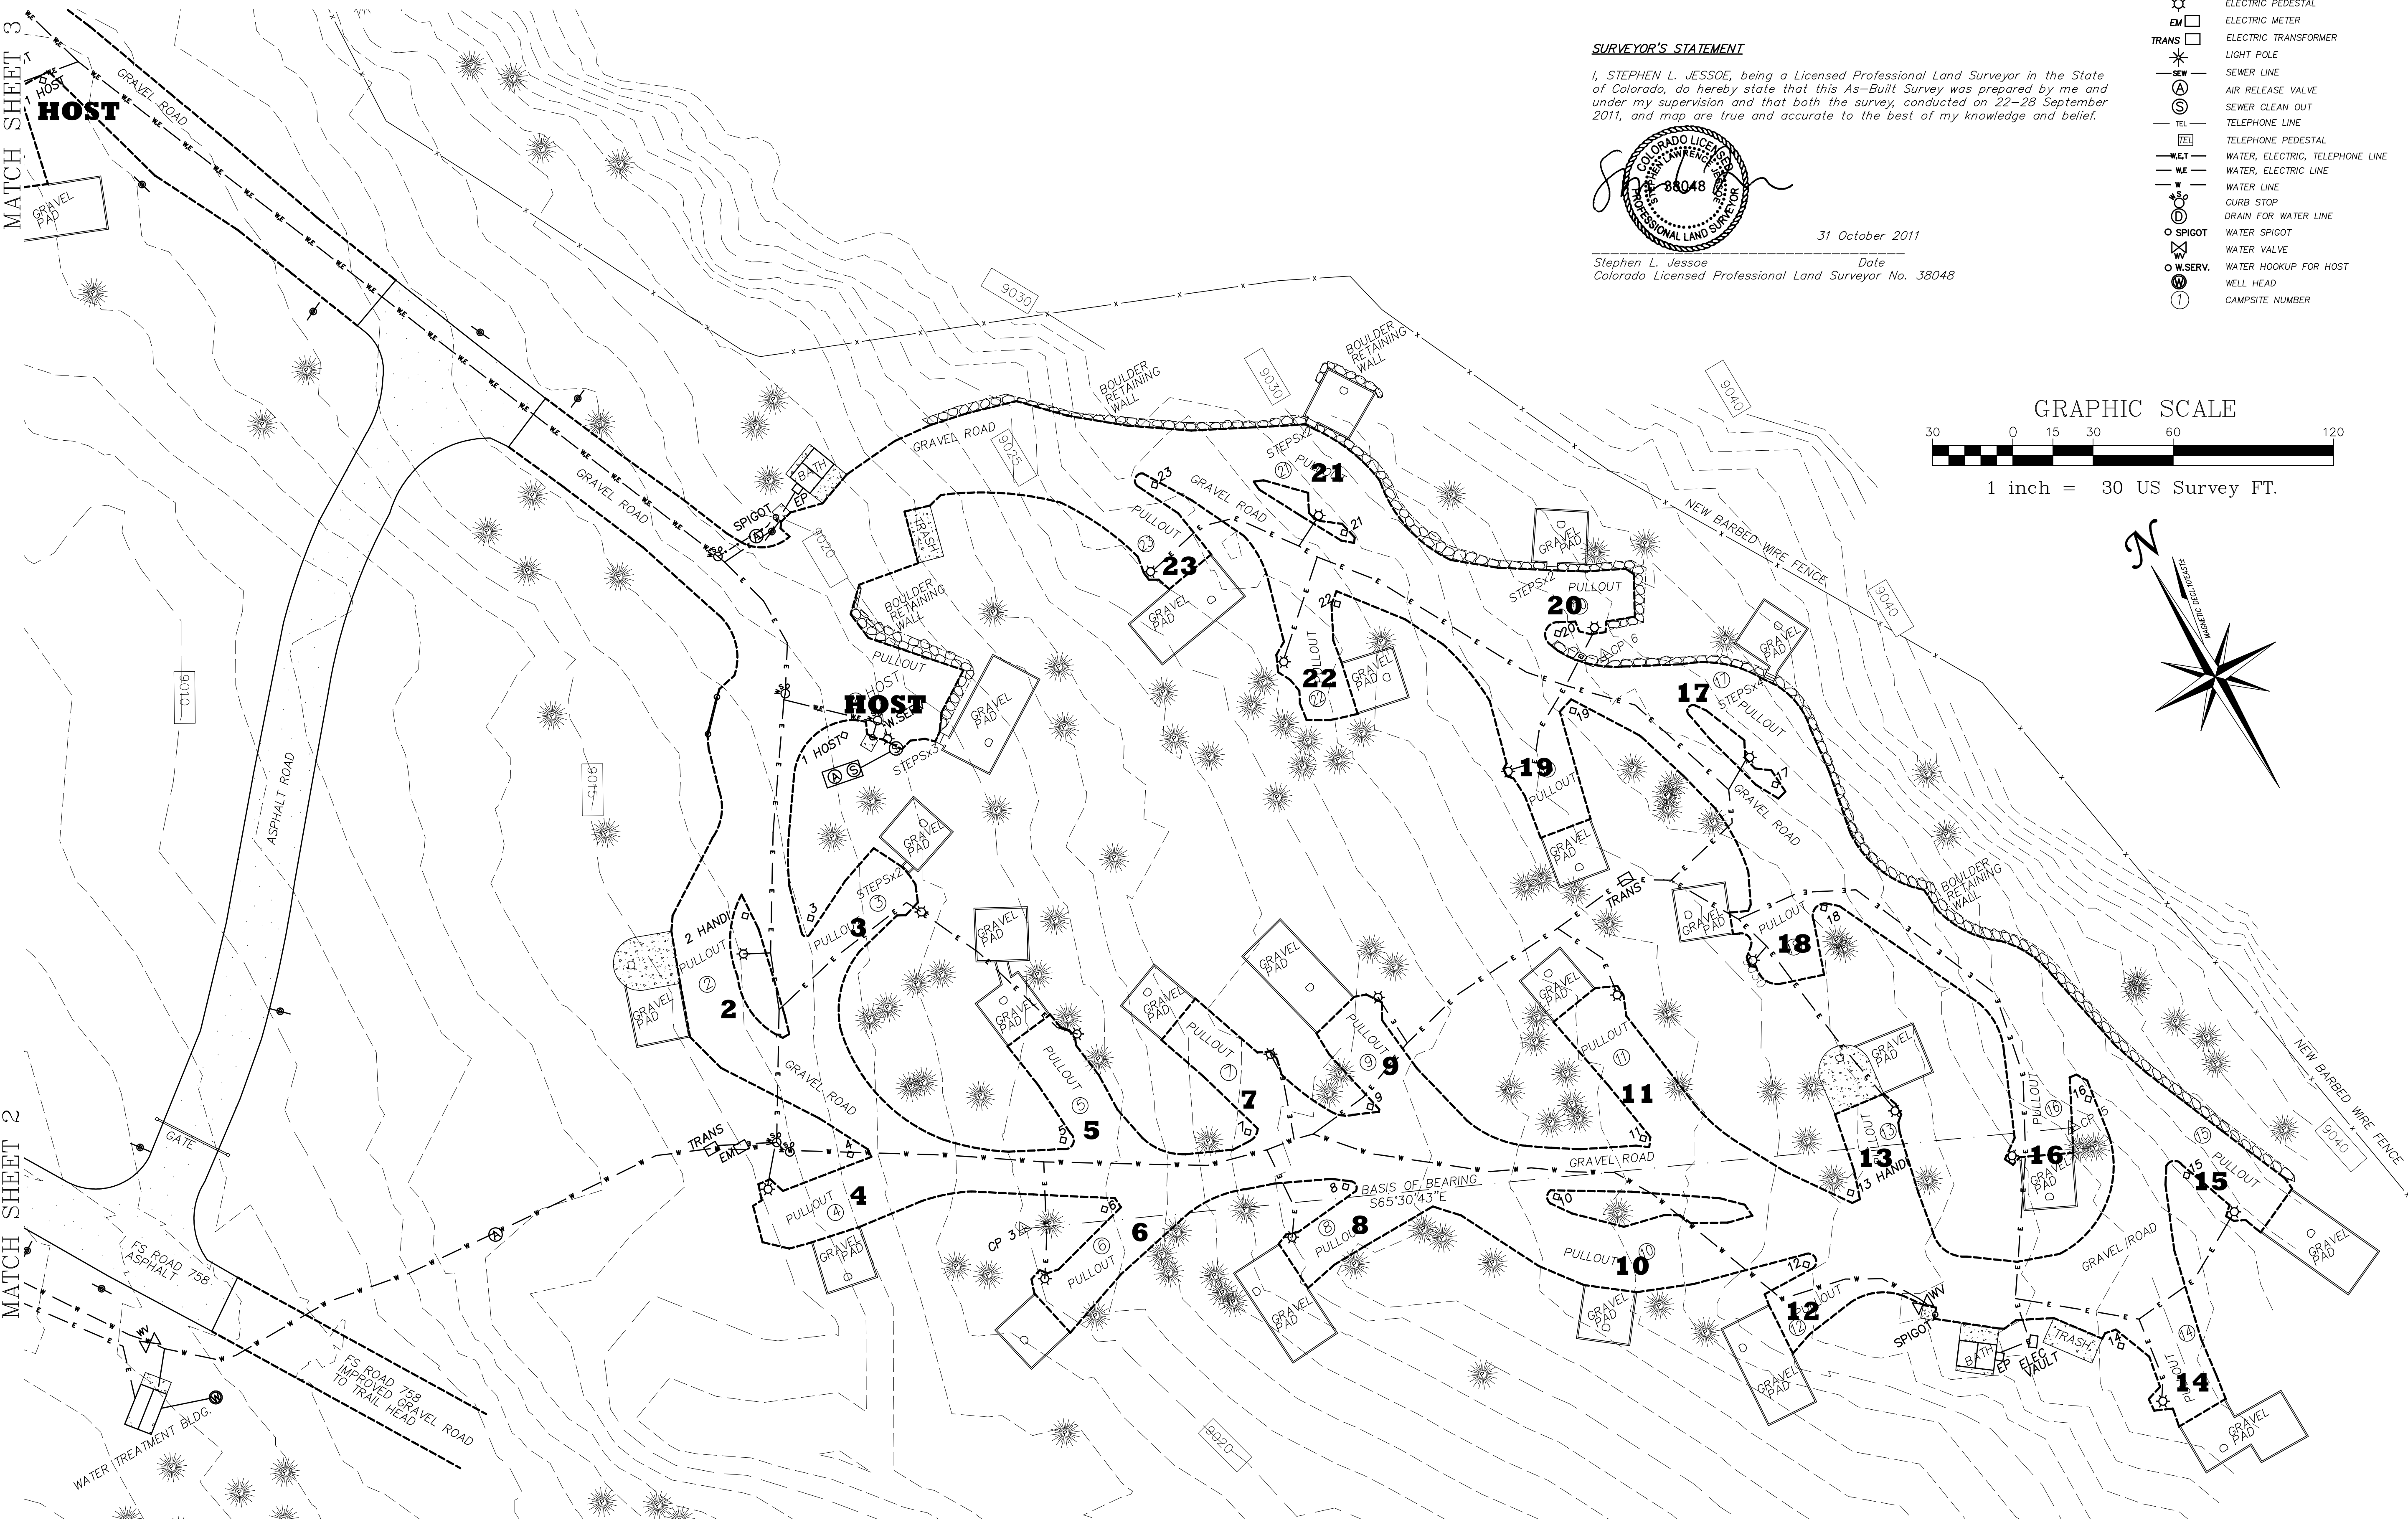

LAND DESCRIPTION


Lottis Creek Campground – Union Park Loop
U.S. Forest Service – Gunnison National Forest
Section 2, T 15 S, R 83 W, 6th P.M.
County of Gunnison
State of Colorado

SURVEY NOTES

- 1) Elevations, survey control, topographic information and tree locations provided by the US Forest Service, Gunnison Office.
- 2) Basis of bearing based upon control points CP-3 and CP-5 as shown hereon. Control information provided by the US Forest Service, Gunnison office.
- 3) Distances and dimensions are in U.S. Survey Feet.

SURVEYOR'S STATEMENT

I, STEPHEN L. JESSOE, being a Licensed Professional Land Surveyor in the State of Colorado, do hereby state that this As-Built Survey was prepared by me and under my supervision and that both the survey, conducted on 22-28 September 2011, and map are true and accurate to the best of my knowledge and belief.



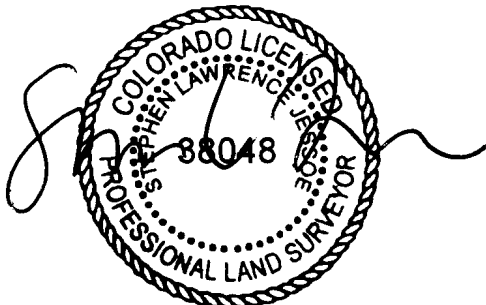


31 October 2011

Stephen L. Jessoe Date
Colorado Licensed Professional Land Surveyor No. 38048

LEGEND

- SURVEY CONTROL
- FIRE PIT
- TRAFFIC SIGN
- CAMP SITE SIGN
- BOULDER RETAINING WALL
- CONCRETE PAD
- ASPHALT
- GRAVEL EDGE
- BARBED WIRE FENCE
- TIMBERS
- ELECTRIC LINE
- ELECTRIC PANEL
- ELECTRIC PEDESTAL
- ELECTRIC METER
- ELECTRIC TRANSFORMER
- LIGHT POLE
- SEWER LINE
- AIR RELEASE VALVE
- SEWER CLEAN OUT
- TELEPHONE LINE
- TELEPHONE PEDESTAL
- WATER, ELECTRIC, TELEPHONE LINE
- WATER, ELECTRIC LINE
- WATER LINE
- CURB STOP
- DRAIN FOR WATER LINE
- WATER SPIGOT
- WATER VALVE
- WATER HOOKUP FOR HOST
- WELL HEAD
- CAMP SITE NUMBER

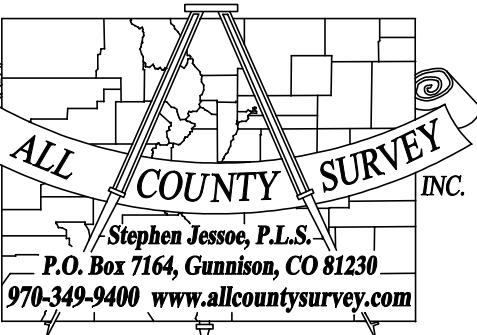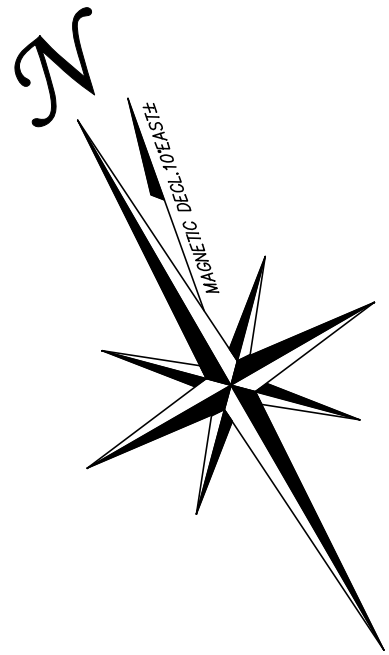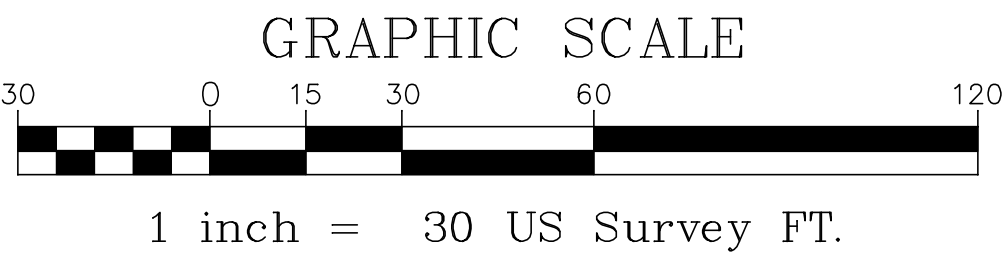

AS-BUILT SURVEY
LOTTIS CREEK CAMPGROUND – UNION PARK LOOP
FOREST SERVICE ROAD 758
GUNNISON COUNTY, COLORADO

SCALE: 1" = 30'
CONTOUR INTERVAL: 2 FEET
CONTOURS FROM BASE MAP
PROVIDED BY FOREST SERVICE

According to Colorado Law, you must commence any legal action based upon any defect in this survey within three years after you first discover such defect, in no event may any legal action based upon any defect in this survey be commenced more than ten years from the date of the certification shown hereon.

DATE: 10/31/11
DRAWN BY: ADJ
REVIEWED BY: SLJ

REVISIONS:

AS-BUILT SURVEY
LOTTIS CREEK CAMPGROUND
TAYLOR RIVER ROAD
Sec.2, T15S, R83W, 6th PM
GUNNISON COUNTY, COLORADO